


Brickell Bay Drive




Biscayne Bay

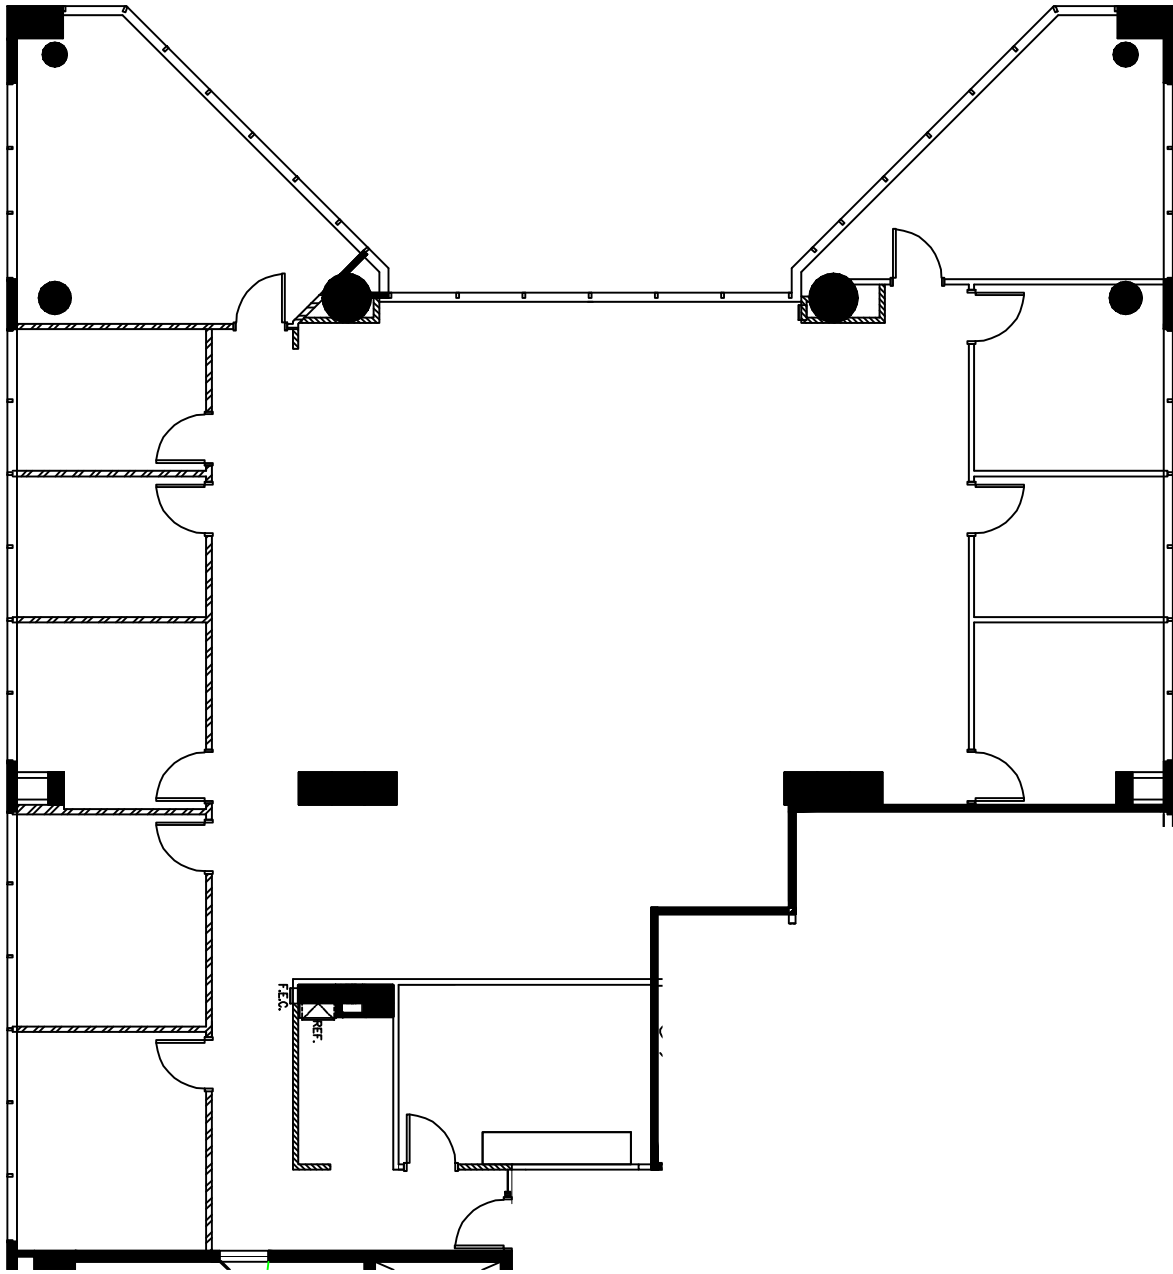

AS-BUILT  
SUITE 1600 WEST

NOT TO SCALE

February 21, 2014

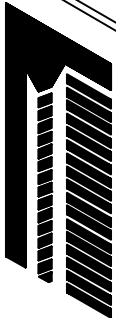

BRICKELL BAY  
OFFICE TOWER

1001  
Brickell Bay Drive

Miami  
Florida 33131

Telephone  
305 536 1001

Facsimile  
305 374 8644