


Brickell Bay Drive




Biscayne Bay

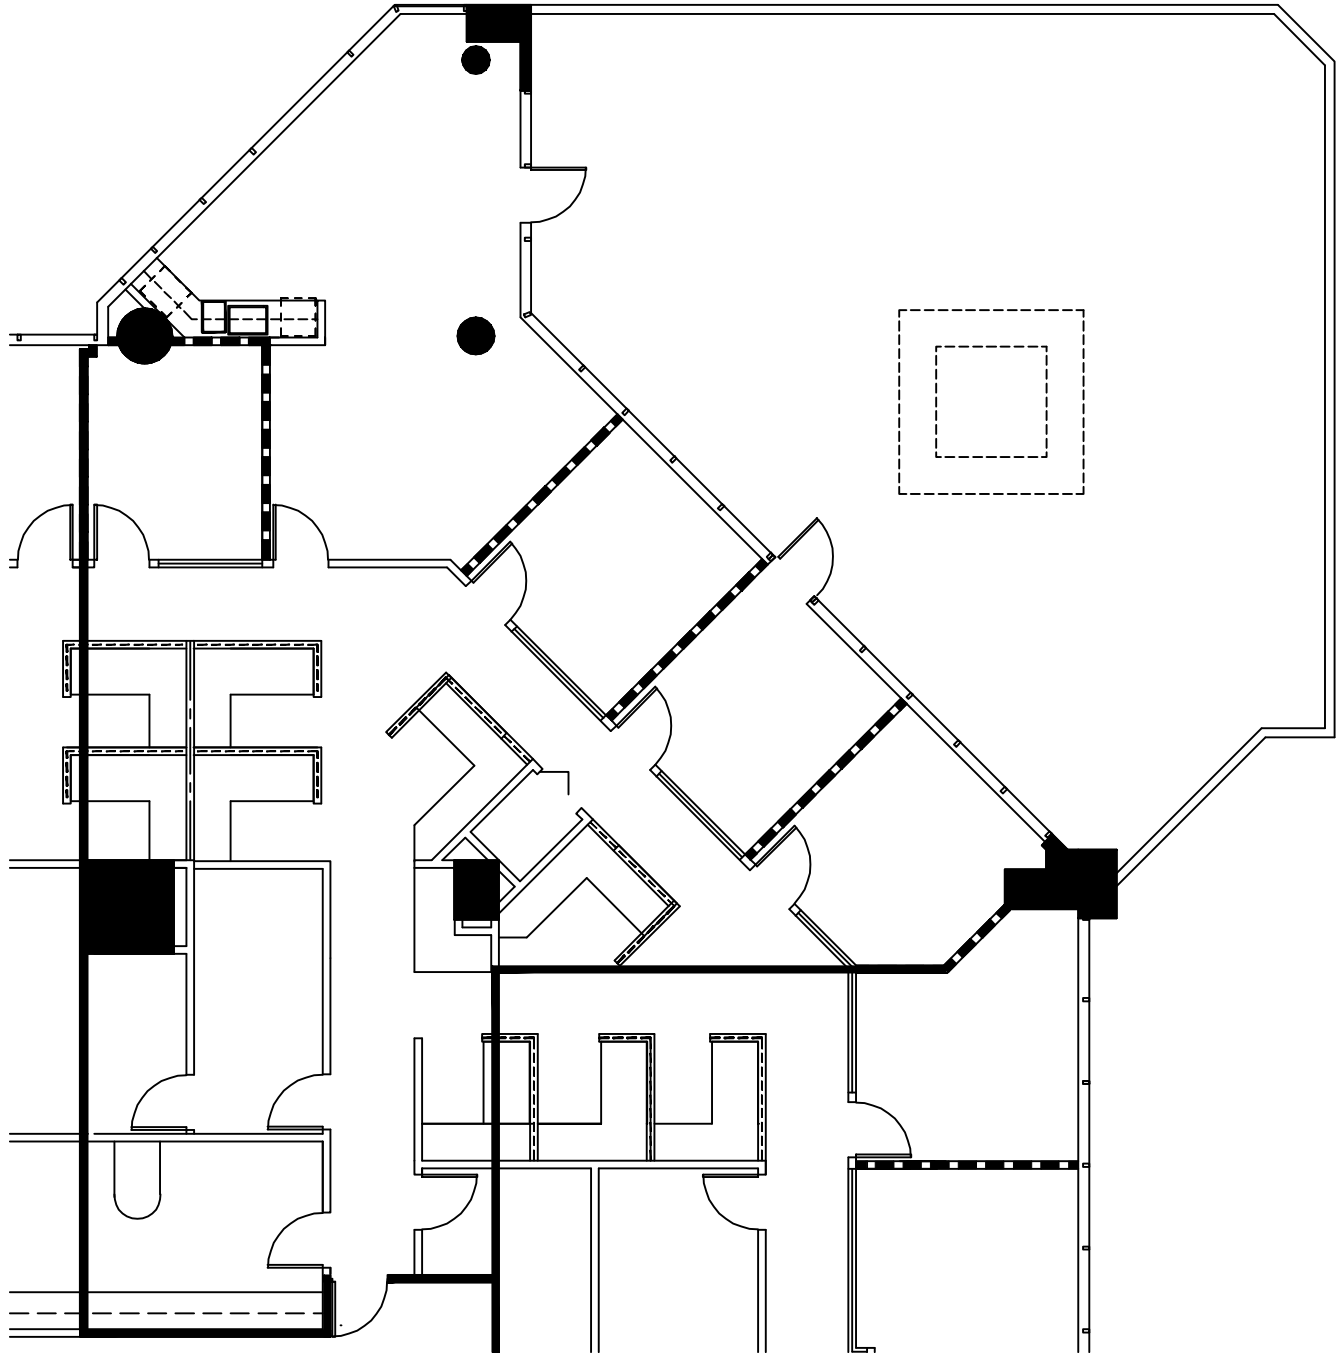

AS-BUILT  
SUITE 912

NOT TO SCALE

December 21, 2013

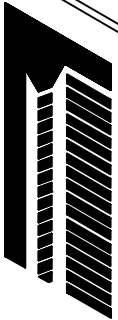

BRICKELL BAY  
OFFICE TOWER

1001  
Brickell Bay Drive

Miami  
Florida 33131

Telephone  
305 536 1001

Facsimile  
305 374 8644